

TEST

Z1 - 2T

Z2 - 5T

15

Z3 - 12S

2T

Z4 1T

MAIN BUILDING

ALARM ZONES 1, 2 & 3

SCALE 1 : 150






A3	0	DT-01	DRAWING No.	JOB No.	DESIGNED BB	DRAWN RCB	CHECKED BB	SCALE 1:150	DATE 13-02-2009	No. IN SET 1 of 1	FIRE SERVICES PARADISE FIRE STATION DETECTORS & ALARMS AS INSTALLED

Safe Fire Electrical
 Fire Systems (SA) PTY LTD
 Trading as
 100 South Road, Torrensville SA 5031
 Telephone: (08) 8352 8620
 Facsimile: (08) 8351 8600
 Email: info@safefire.com.au
 ABN 45 109 996 876

SA Metropolitan Fire Service
 57 DARLEY RD, PARADISE SA 5075
 JOB

REVISION	DESCRIPTION	DATE
0	Preliminary Issue	13-02-2009
-	Detector Tag AZ2-044-T (Room 1.08) was AZ2-049-T	13-02-2009

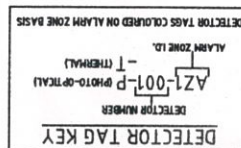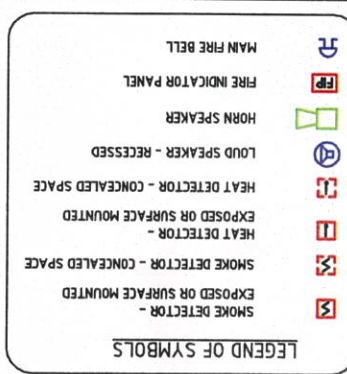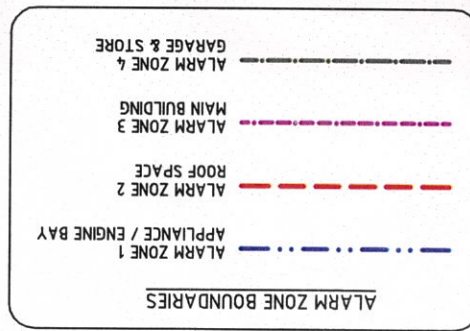

NOTES:
 1. HORN SPEAKERS IN ENGINE/APPLIANCE BAYS
 ARE ON A TIMER & WILL NOT OPERATE AFTER 7:00
 P.M. OR BEFORE 8:00 A.M. ON ANY DAY.

